


LEGEND:

- 1) I.P.S. - IRON PIN SET (#5R.)
- 2) I.P.F. - IRON PIN FOUND
- 3) R. - REINFORCING BAR
- 4) A - ARC
- 5) RAD. - RADIUS
- 6) (R) - NOT RADIAL
- 7) (NR) - NOT RADIAL
- 8) M.H. - MANHOLE
- 9) D.I. - DROP INLET LINE
- 10) R/W - RIGHT-OF-WAY
- 11) J.B. - JUNCTION BOX
- 12) J.B. - JUNCTION BOX
- 13) F.H. - FIRE HYDRANT
- 14) L.L.L. - LAND LOT LINE
- 15) C.B. - CHORD BEARING
- 16) C.D. - CHORD DISTANCE
- 17) N.F. - NOW OR FORMERLY
- 18) S.S. - SANITARY SEWER
- 19) S.S.E. - SANITARY SEWER EASEMENT
- 20) P.P. - POWER & (OR) PHONE POLE
- 21) D.E. - DRAINAGE EASEMENT
- 22) E - CENTERLINE
- 23) E - PROPERTY LINE
- 24) O.P.F. - OVERHEAD POWER LINE
- 25) O.P.F. - OVERHEAD PHONE LINE
- 26) F.F. - FENCE (APPROX. LOC.)
- 27) F.F. - FENCE (APPROX. LOC.)
- 28) S.D. - 6" DITCH (APPROX. LOC.)
- 29) S.D. - 6" DITCH (APPROX. LOC.)
- 30) C.T. - CRIMP TOP
- 31) INV. - INVERT
- 32)
- 33)


| COURSE | BEARING      | DISTANCE |
|--------|--------------|----------|
| 1      | N 61°43'55"E | 24.94'   |
| 2      | N 52°16'05"E | 41.79'   |
| 3      | N 44°01'55"E | 39.07'   |
| 4      | N 37°13'05"E | 36.16'   |
| 5      | N 27°28'05"E | 38.48'   |
| 6      | N 24°14'05"E | 113.92'  |
| 7      | N 23°47'45"E | 159.25'  |
| 8      |              |          |

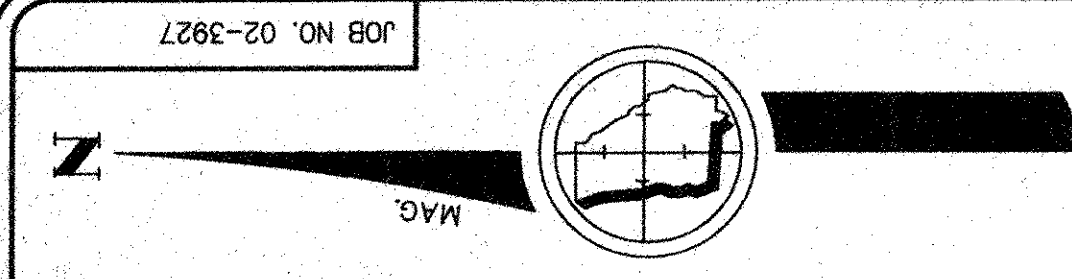

| WATER LEGEND: |                           |
|---------------|---------------------------|
| D.I.W.M.      | - DUCTILE IRON WATER MAIN |
| W.V.          | - WATER VALVE             |
| F.H.          | - FIRE HYDRANT            |
| D.W.S.        | - DOUBLE WATER SERVICE    |
| S.W.S.        | - SINGLE WATER SERVICE    |

REVISIONS:  
1) OCT. 1, 2002: TO UPDATE AS-BUILT INFORMATION.  
2)

THIS AS-BUILT PLAN IS BASED ON ABOVE GROUND INSPECTION ONLY. SIZES AND MATERIALS ARE NOT CERTIFIED.

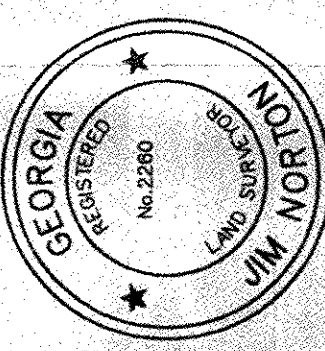

OWNER - DEVELOPER  
REBECCA A. MARTIN INC.  
REBECCA MARTIN  
1487 KINCAID ROAD  
MARIETTA, GA 30066  
OFFICE: (770) 928-6184  
(24 HOUR)

AREA = 16.53 ACRES

DO NOT RECORD!

**MARTIN & NORTON, INC.**  
104 HAYWOOD DRIVE  
P.O. BOX 715  
LEBANON, GEORGIA 30146  
PHONE: (770) 928-0200  
**M&N** LAND SURVEYING & MAPPING SOCIETY OF GEORGIA

THE FIELD DATA UPON WHICH THIS PLAN IS BASED HAS A CLOSURE PRECISION OF ONE FOOT IN 22,000+ FEET AND AN ANGULAR ERROR OF 05" PER ANGLE POINT, AND WAS ADJUSTED USING COMPASS RULE.  
THIS PLAN HAS BEEN CALCULATED FOR CLOSURE AND FOUND TO BE ACCURATE WITHIN ONE FOOT IN 100,000+ FEET.  
EQUIPMENT USED FOR MEASUREMENTS: TOPCON GTS-2B, A(OR), TOPCON GTS-303  
\* ALL MATTERS OF TITLE ARE "EXCEPTED"

WATER SYSTEM AS-BUILT  
OF  
**THE VILLAS AT DOWNING CREEK**  
DISTRICT 15, SECTION 2  
LAND LOTS 84  
CITY: CANTON  
CHEROKEE COUNTY, GEORGIA  
PREPARED: AUGUST 02, 2002  
DRAWN BY: ERIC M. HOLCOMB  
DWG FILE: J3927-H20-ASBL-T-2.dwg  
JOB NO. 02-3927

